


GISLink: 10094

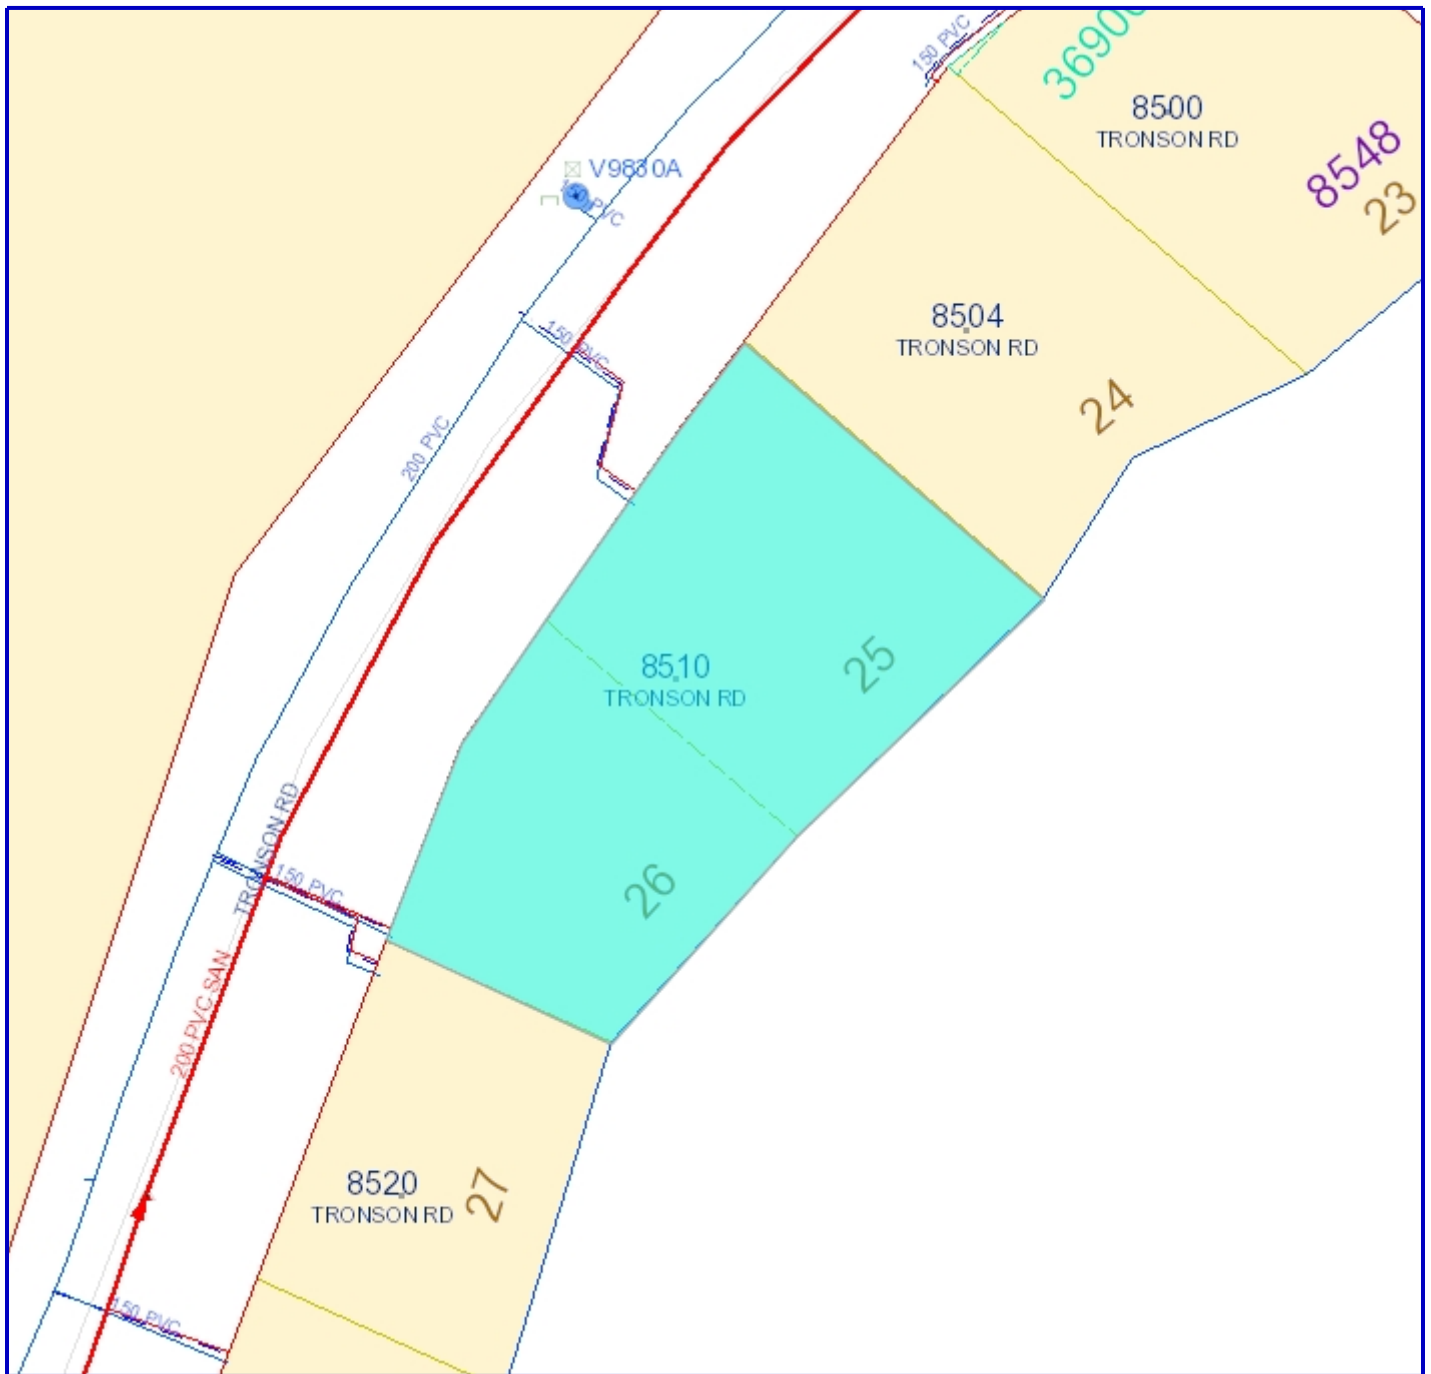

Not to Scale

NOTICE OF LIMITATION: Take notice that the information on this document has been provided to the City by someone other than City staff and is kept for City records only. The City does not and cannot say that the information contained on the document is accurate. In particular, the location and depth of any utility requires confirmation by manual excavation prior to any associated design or construction. Please govern yourself accordingly.

Service Card Report



Property Address:
8510 TRONSON RD

Folio: Legal Type:
07861.220 LAND

Long Form Legal:
LOT 25-26 PLAN 8548 DISTRICT LOT 298 OSOYOOS DIVISION YALE DISTRICT

Card No.	Service Type	Size	Material	Location
032511	WATER	38MM	PEX	1.1M NE OF SW IP
032512	SANITARY	50MM	PE	1.22M NE OF SW IP
032513	WATER	38MM	PEX	10.29M SW OF NW IP OR 21.4M NE OF SW IP
032514	SANITARY	50MM	PE	10.29M SW OF NW IP

NOTICE OF LIMITATION: Take notice that the information on this document has been provided to the City by someone other than City staff and is kept for City records only. The City does not and cannot say that the information contained on the document is accurate. In particular, the location and depth of any utility requires confirmation by manual excavation prior to any associated design or construction. Please govern yourself accordingly.